

CA·UK·IN

CAUKIN STUDIO LTD.
info@caukinstudio.com
www.caukinstudio.com

Do not scale from this drawing.


This drawing is to be read in conjunction with all other consultants' drawings and specifications for the project. Representation of structural elements is purely indicative. All structural elements to be specified by a certified structural engineer.

This drawing is the copyright of CAUKIN Studio Ltd (registered in England). Reproduction without the express consent of CAUKIN Studio Ltd is prohibited and the information contained on this drawing may not be used for any purpose other than that which is stated on this drawing.

Project:
NAIDI

Drawing:
GA PLAN

Scale:
1:50 @ A3

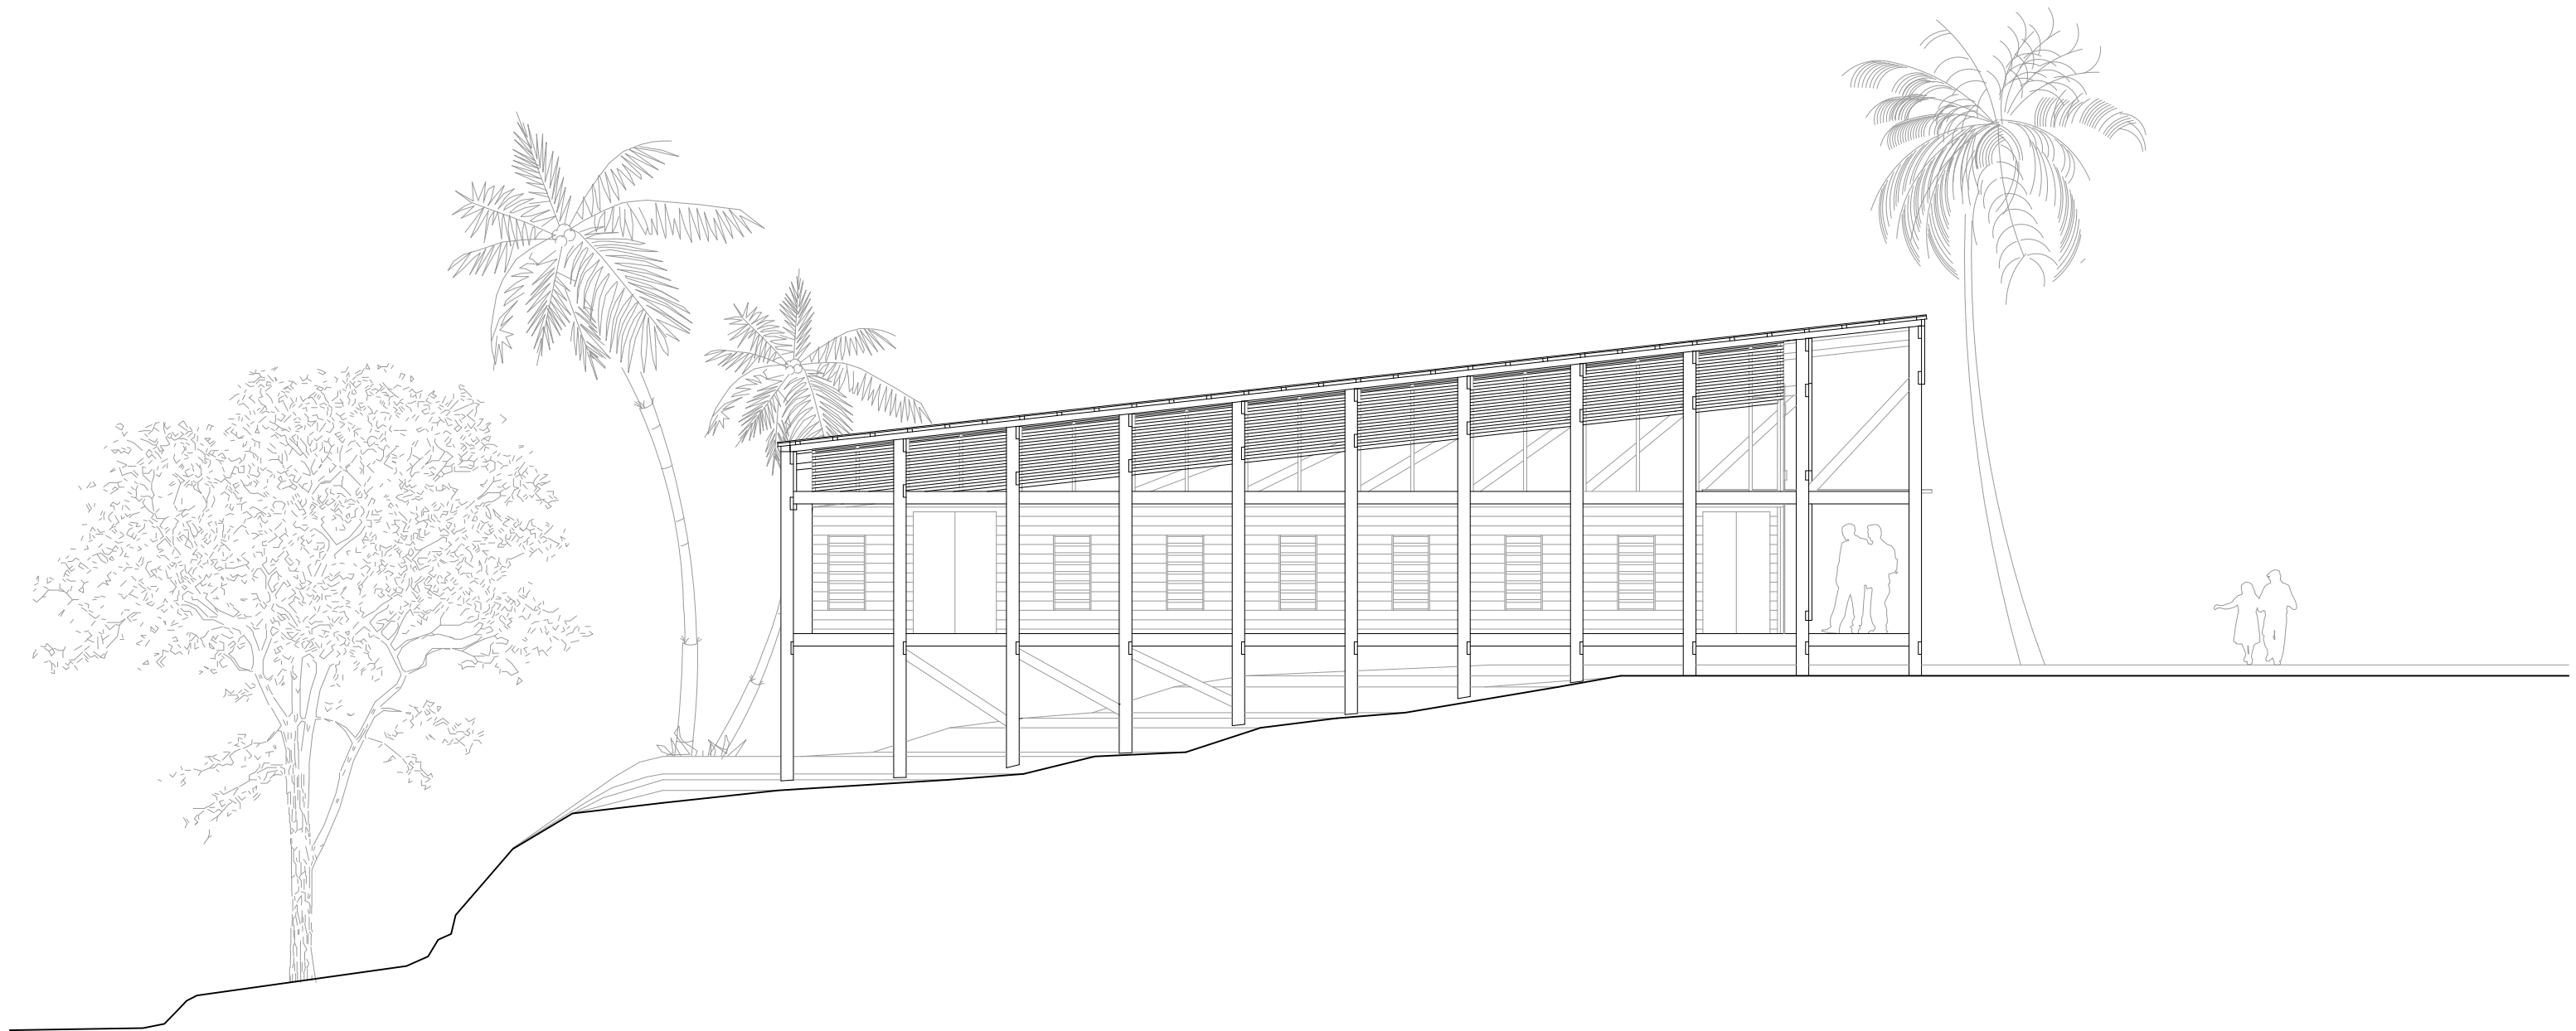

CA·UK·IN

CAUKIN STUDIO LTD.
info@caukinstudio.com
www.caukinstudio.com

Do not scale from this drawing.

This drawing is to be read in conjunction with all other consultants' drawings and specifications for the project. Representation of structural elements is purely indicative. All structural elements to be specified by a certified structural engineer.

This drawing is the copyright of CAUKIN Studio Ltd (registered in England). Reproduction without the express consent of CAUKIN Studio Ltd is prohibited and the information contained on this drawing may not be used for any purpose other than that which is stated on this drawing.

Project:


NAIDI COMMUNITY HALL

Drawing:

NORTH ELEVATION

Scale:

1:100 @ A3

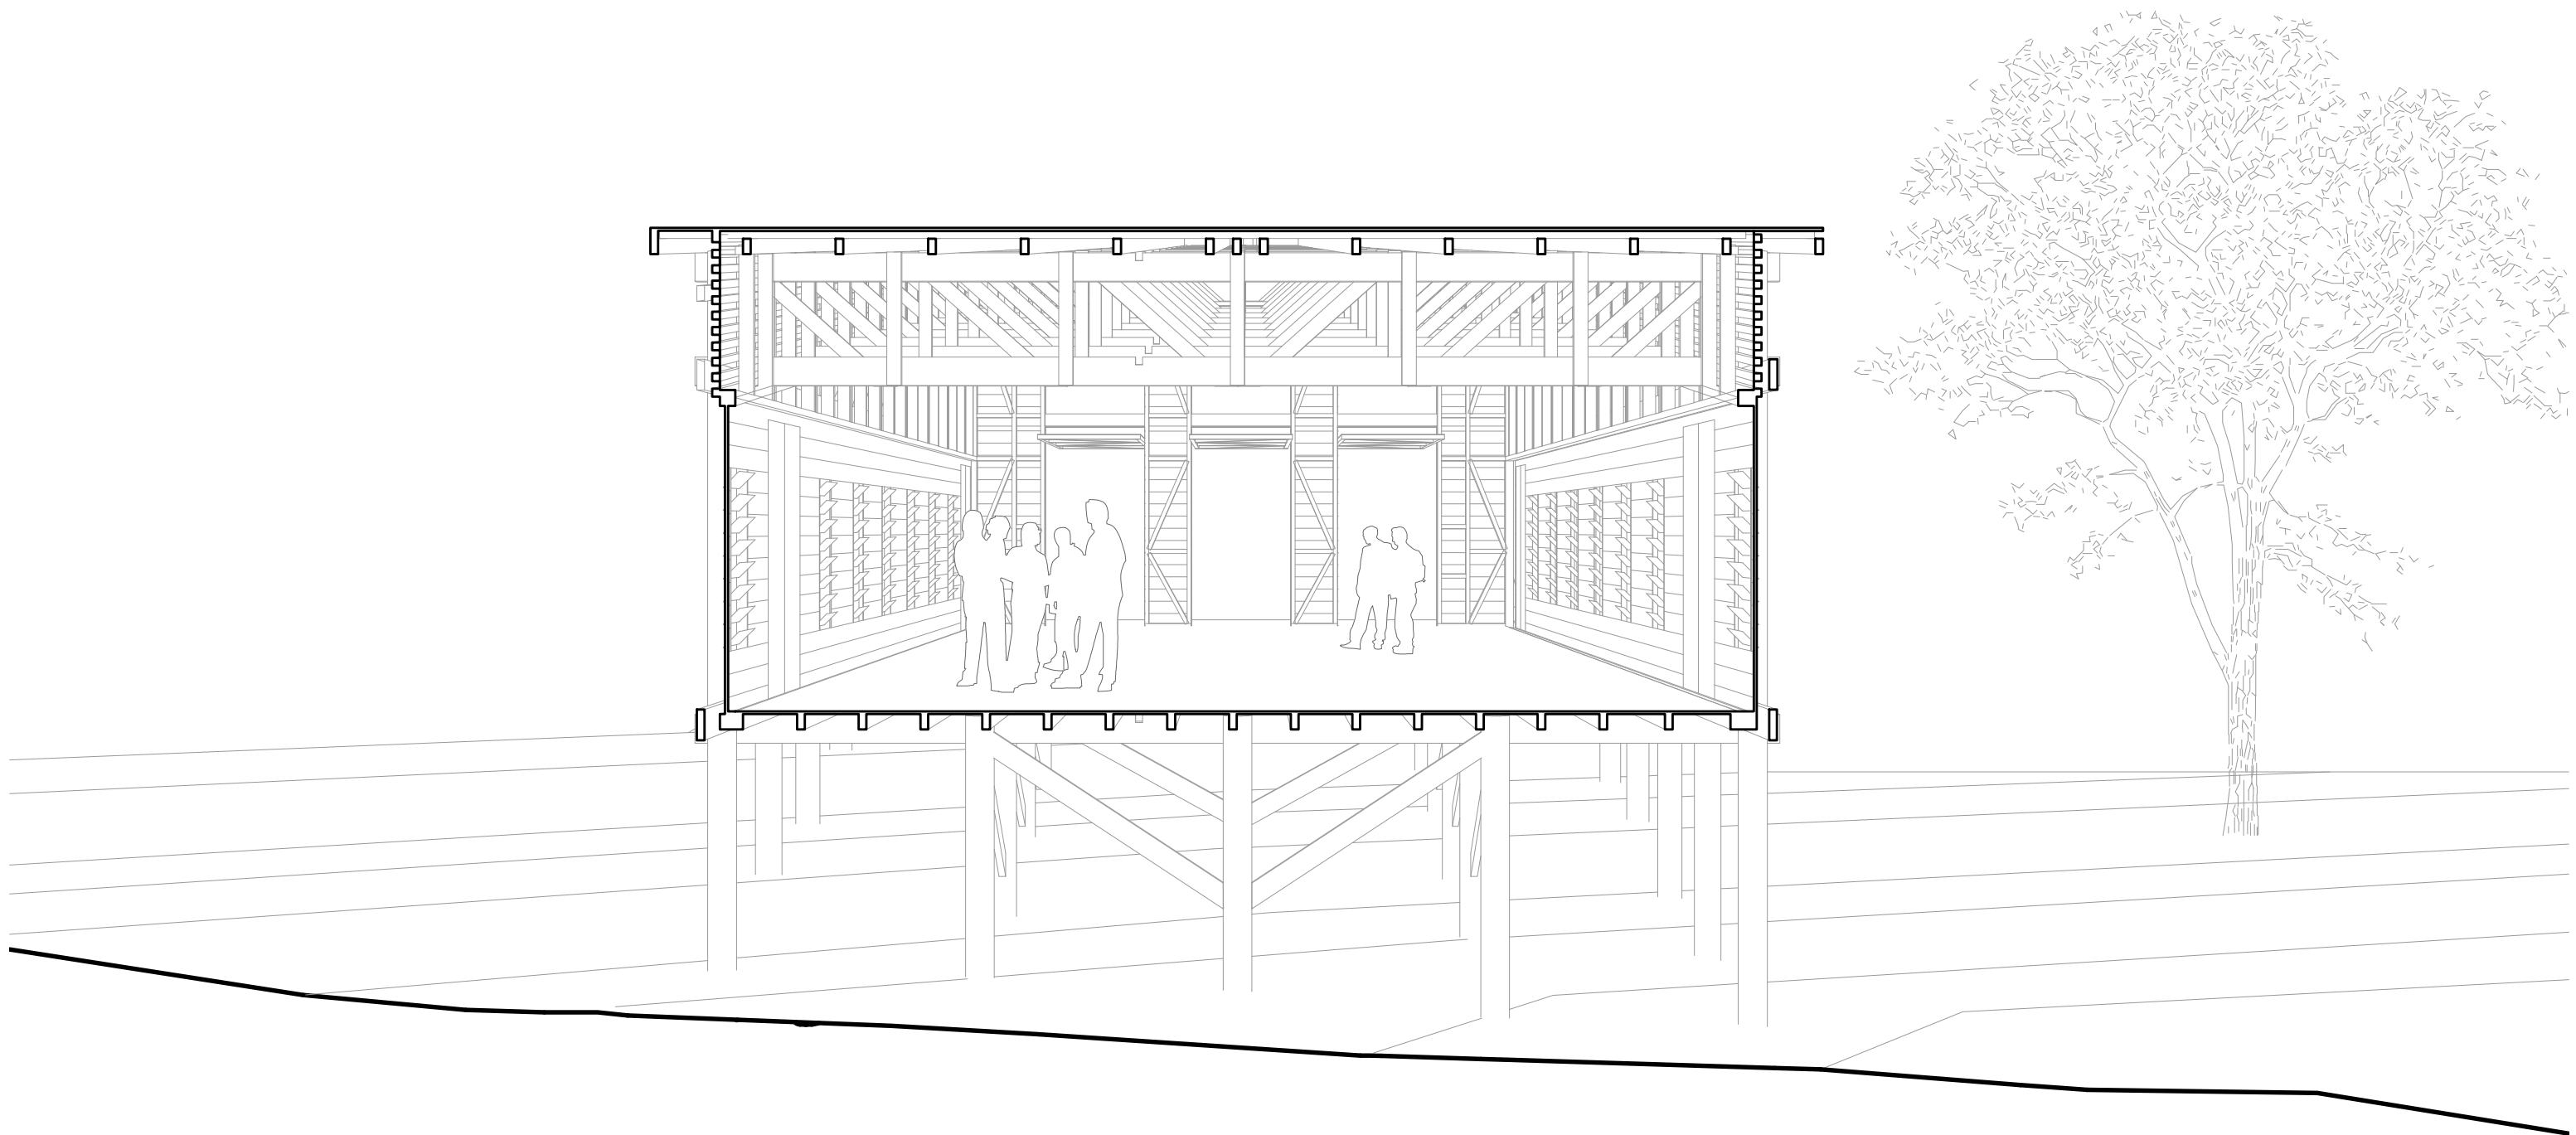

CA·UK·IN

CAUKIN STUDIO LTD.
info@caukinstudio.com
www.caukinstudio.com

Do not scale from this drawing.


This drawing is to be read in conjunction with all other consultants' drawings and specifications for the project. Representation of structural elements is purely indicative. All structural elements to be specified by a certified structural engineer.

This drawing is the copyright of CAUKIN Studio Ltd (registered in England). Reproduction without the express consent of CAUKIN Studio Ltd is prohibited and the information contained on this drawing may not be used for any purpose other than that which is stated on this drawing.

Project:
NAIDI COMMUNITY HALL

Scale: **NTS**

Drawing:
SECTION AA

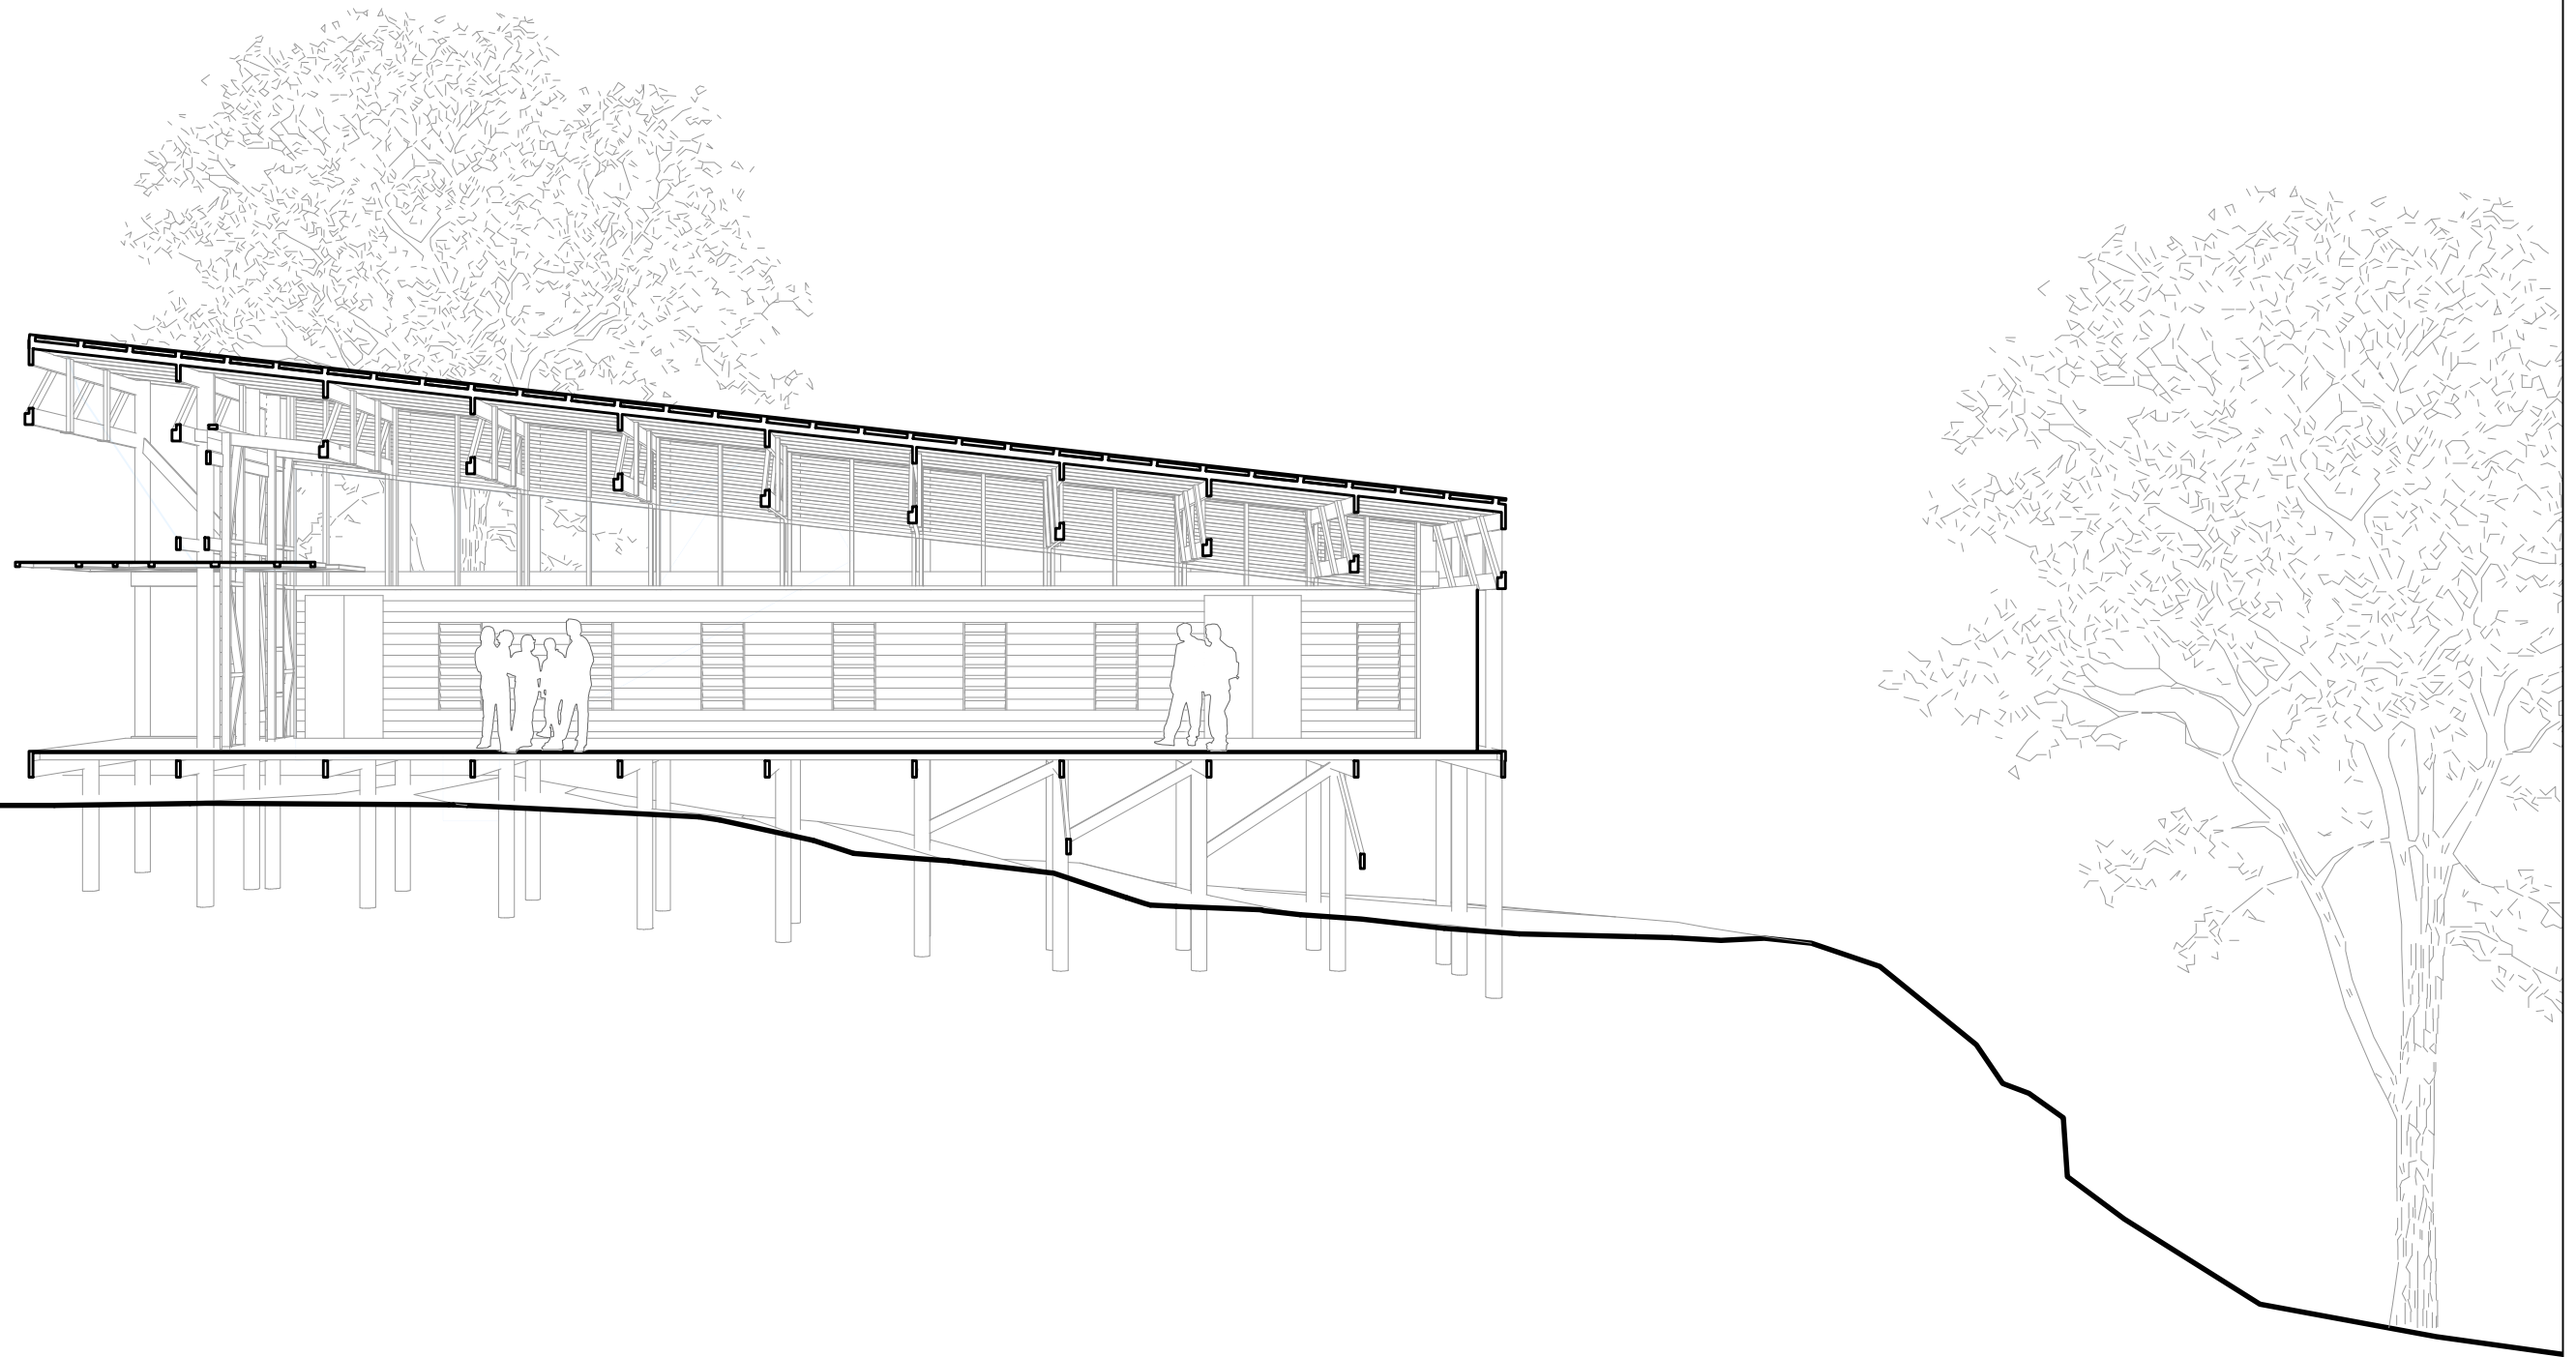

CA·UK·IN

CAUKIN STUDIO LTD.
info@caukinstudio.com
www.caukinstudio.com

Do not scale from this drawing.


This drawing is to be read in conjunction with all other consultants' drawings and specifications for the project. Representation of structural elements is purely indicative. All structural elements to be specified by a certified structural engineer.

This drawing is the copyright of CAUKIN Studio Ltd (registered in England). Reproduction without the express consent of CAUKIN Studio Ltd is prohibited and the information contained on this drawing may not be used for any purpose other than that which is stated on this drawing.

Project:
NAIDI COMMUNITY HALL

Scale: **NTS**

Drawing:
SECTION BB

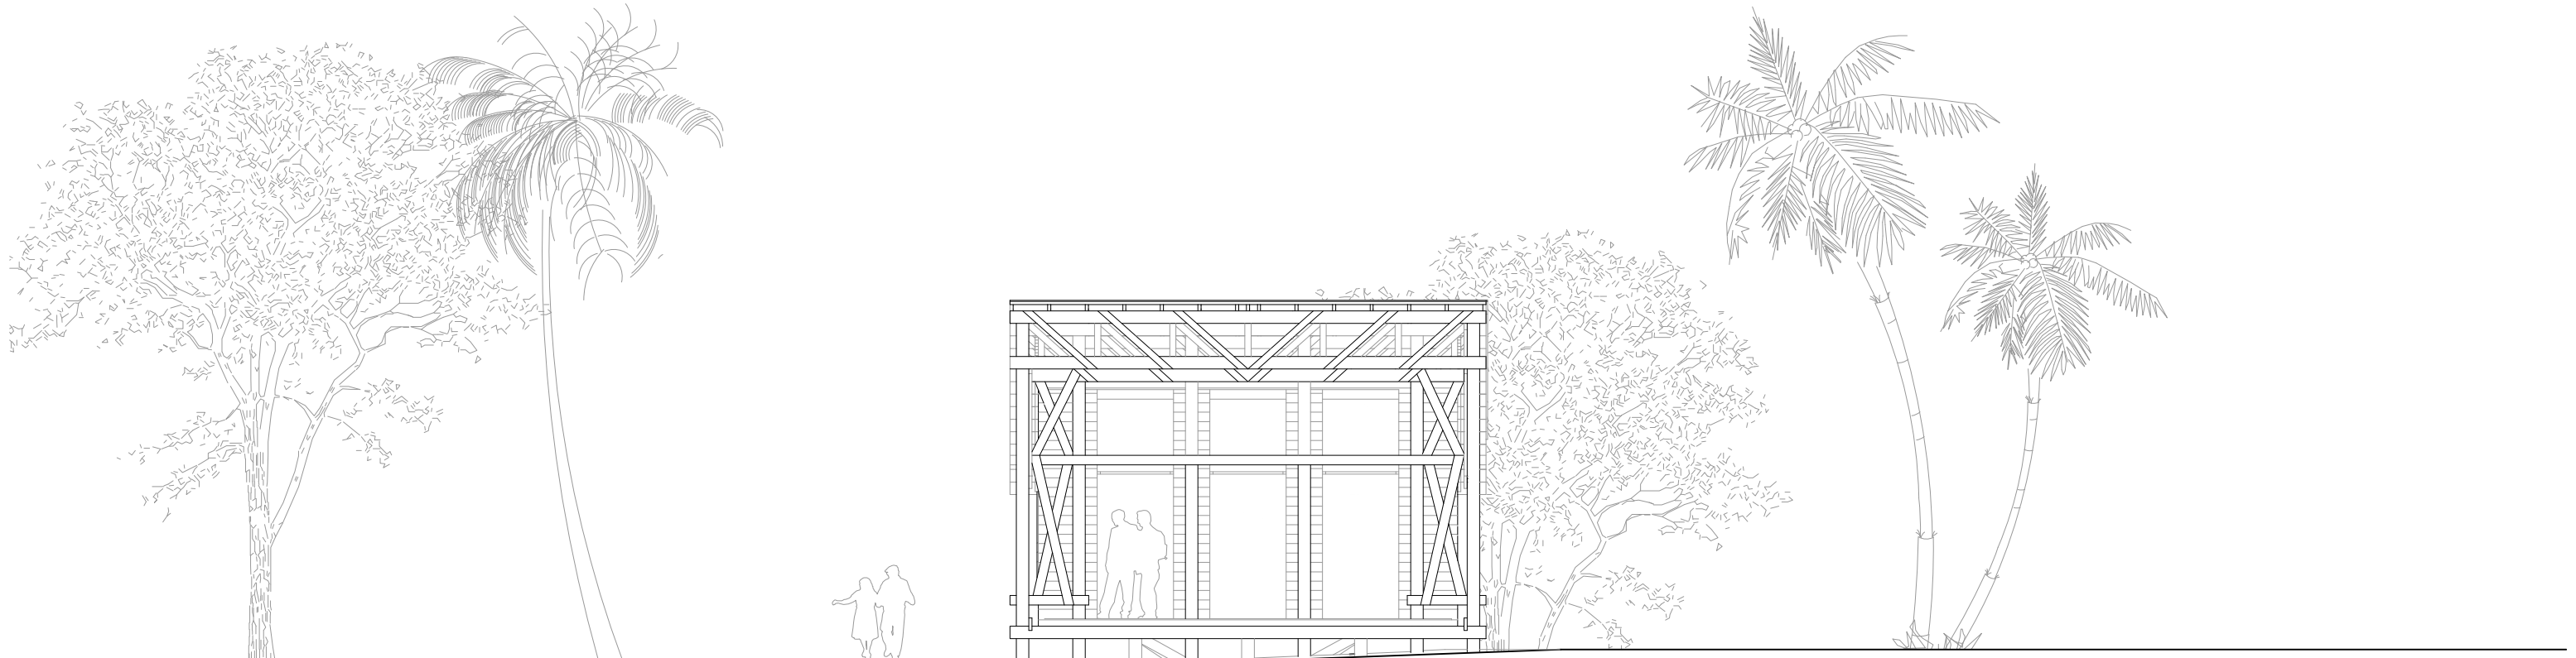

CA·UK·IN

CAUKIN STUDIO LTD.
info@caukinstudio.com
www.caukinstudio.com

Do not scale from this drawing.

This drawing is to be read in conjunction with all other consultants' drawings and specifications for the project. Representation of structural elements is purely indicative. All structural elements to be specified by a certified structural engineer.

This drawing is the copyright of CAUKIN Studio Ltd (registered in England). Reproduction without the express consent of CAUKIN Studio Ltd is prohibited and the information contained on this drawing may not be used for any purpose other than that which is stated on this drawing.

Project:

NAIDI COMMUNITY HALL



Drawing:

WEST ELEVATION



Scale:

1:100 @ A3


ROOF DETAIL

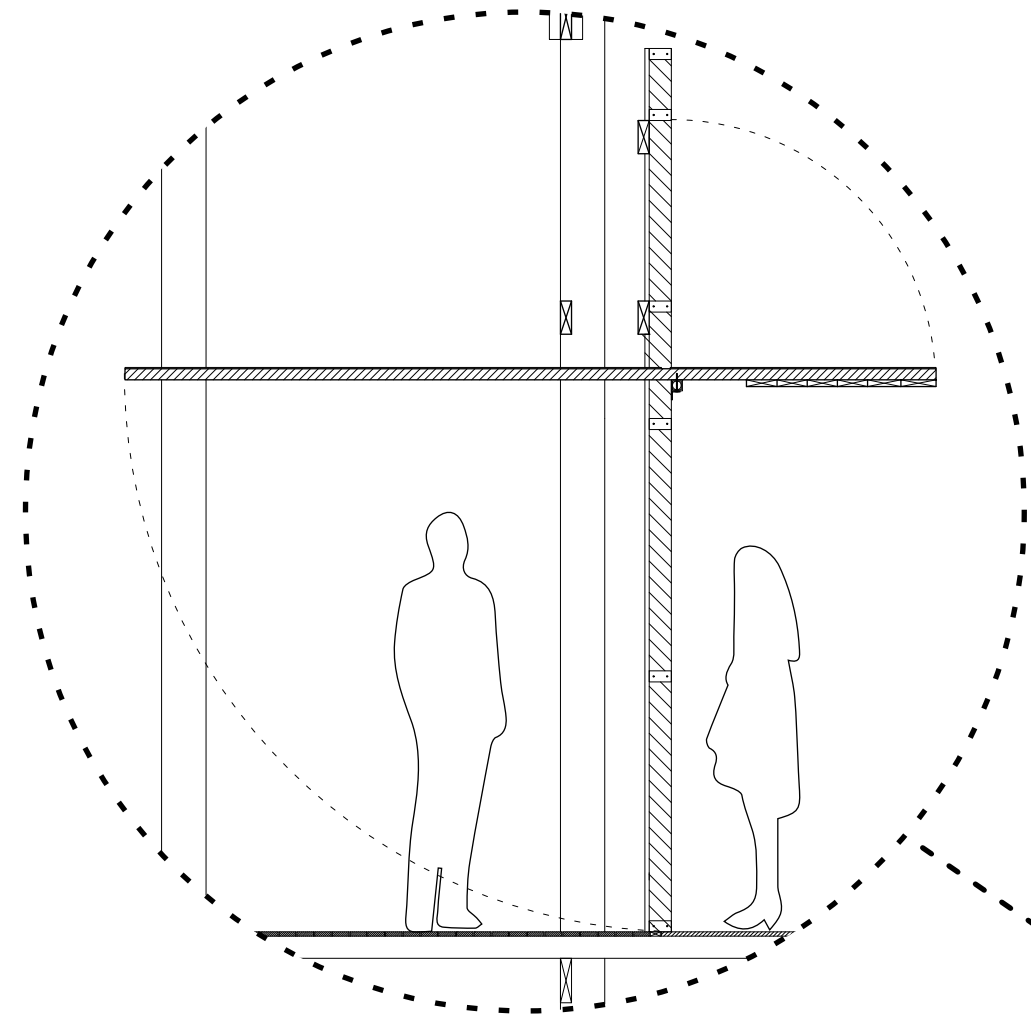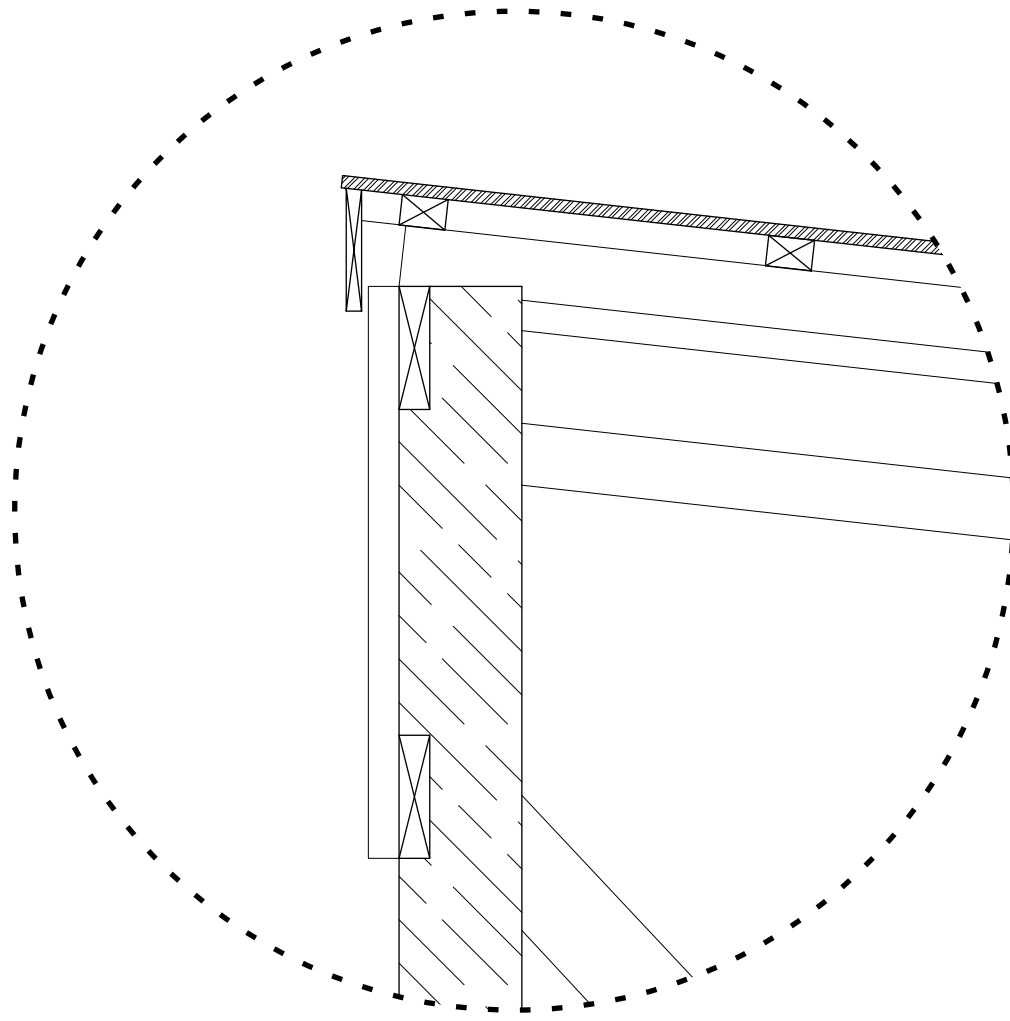

PIVOT DOOR DETAIL

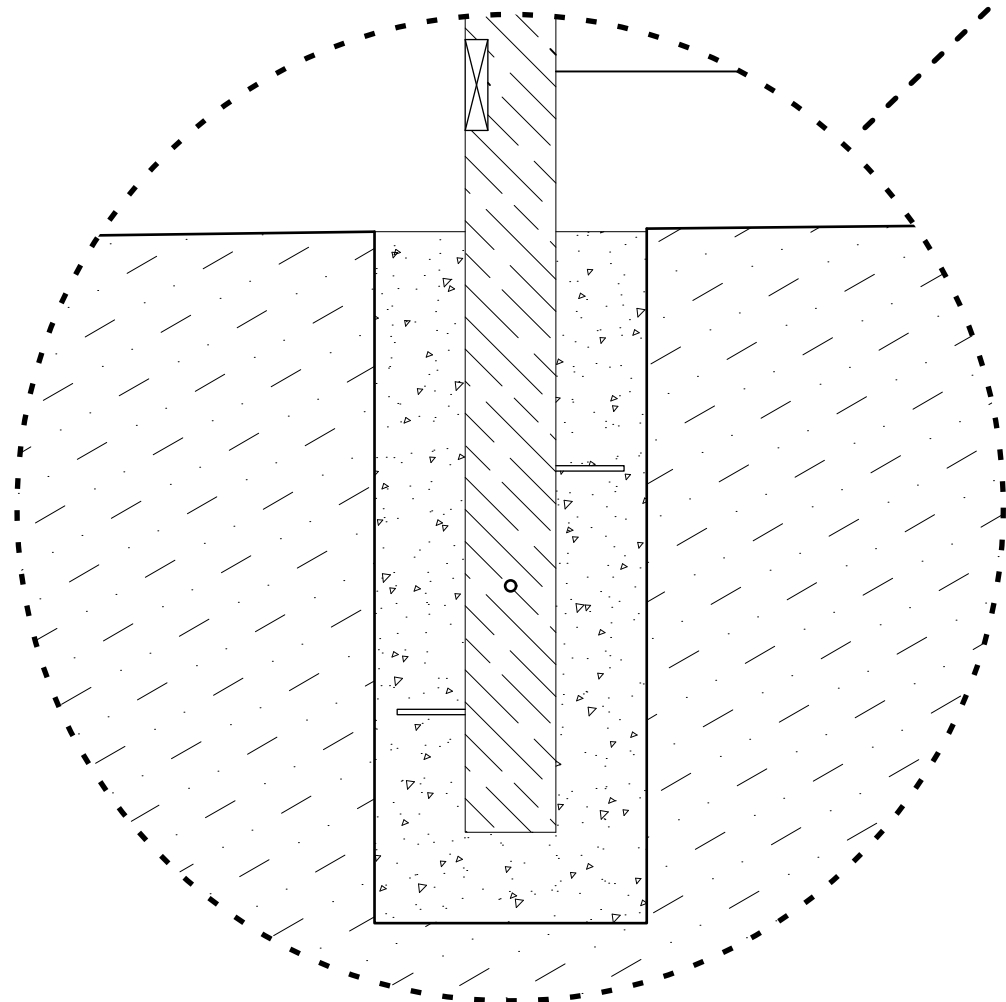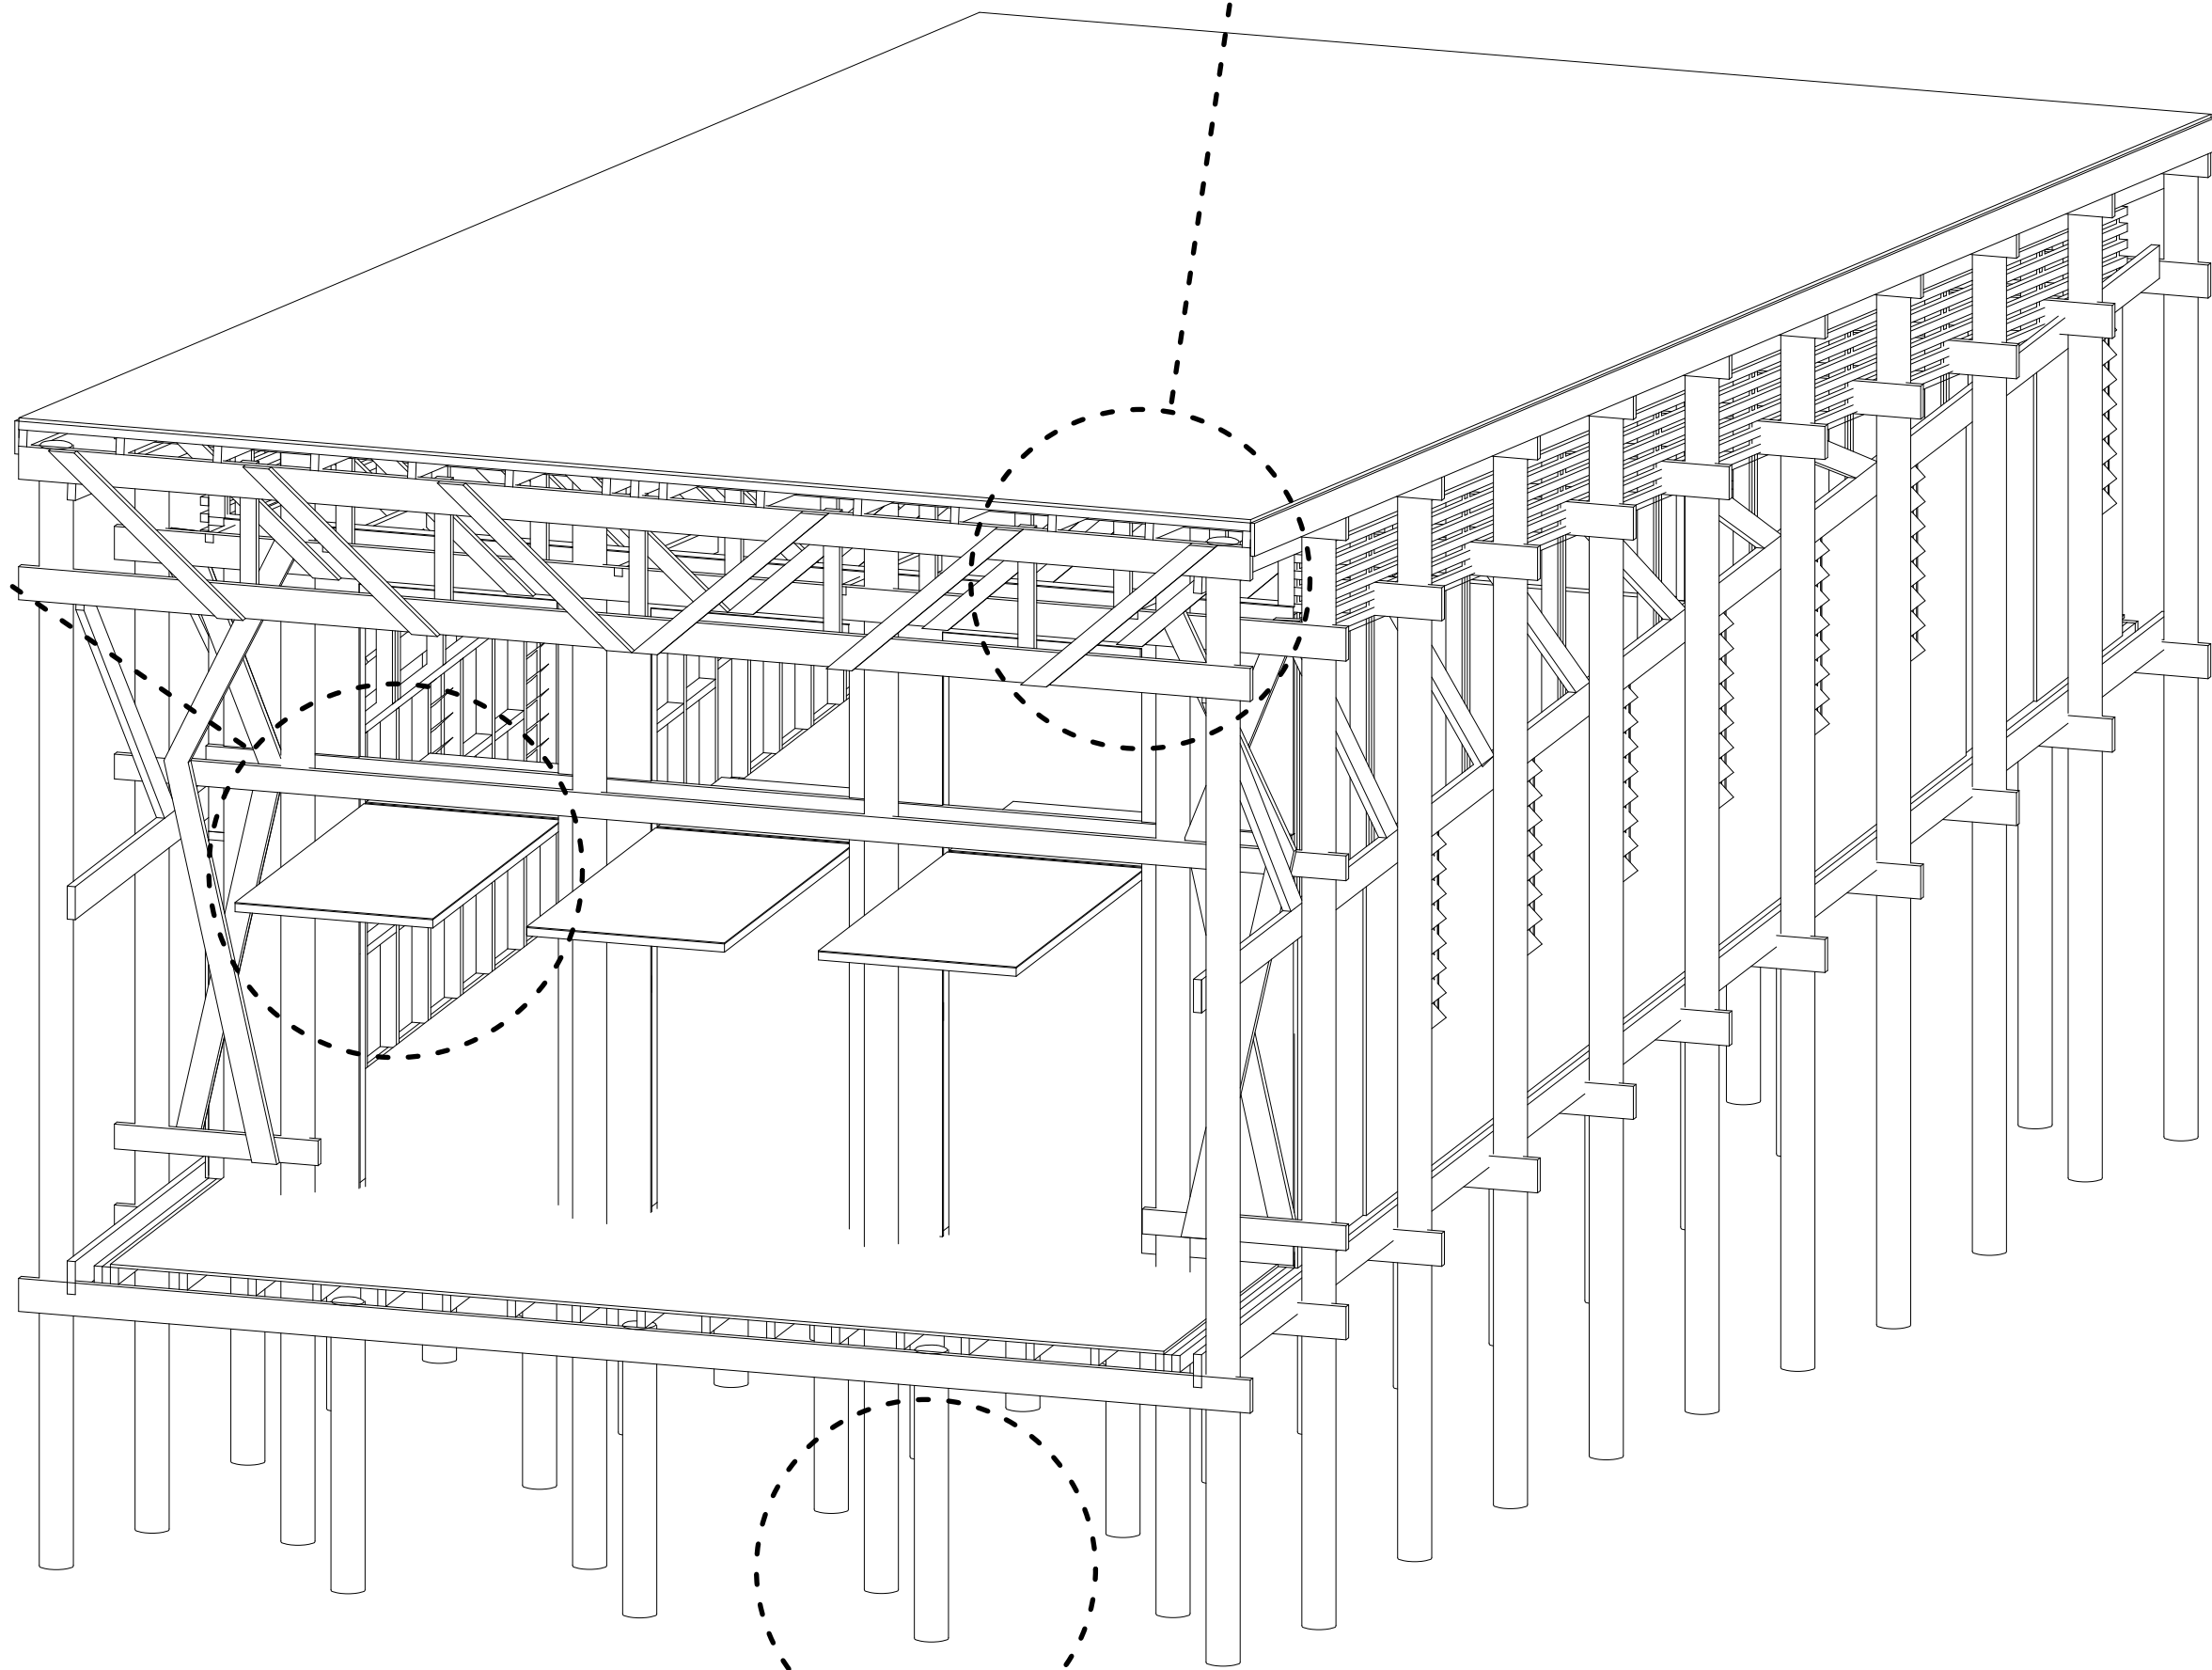


FOUNDATION DETAILS

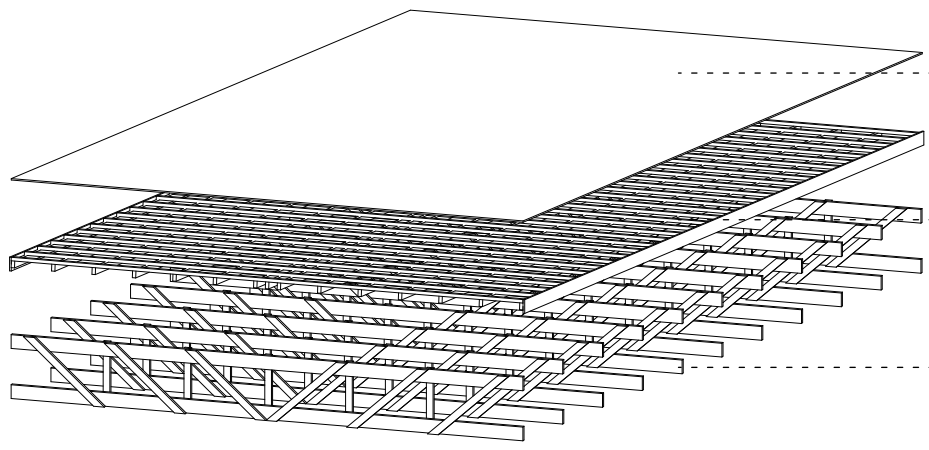

ROOF SHEETING

ROOF RAFTER & PERLINS

ROOF TRUSS

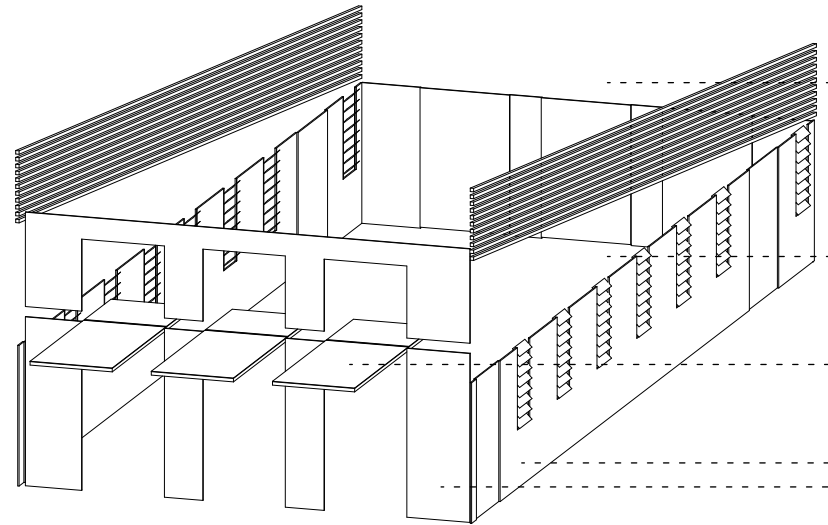


HIT & MISS BATONS


GLASS WINDOW LOUVERS

LARGE PIVOT DOORS


WEATHERBOARD CLADDING

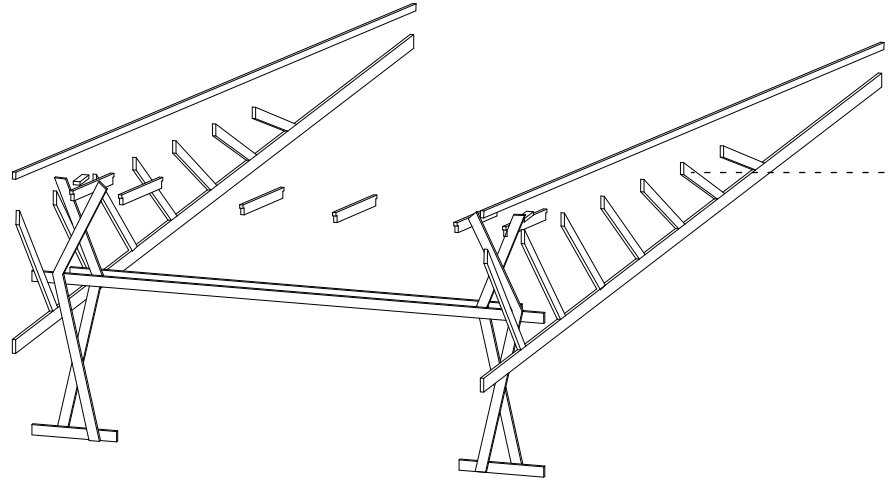


CROSS BRACING

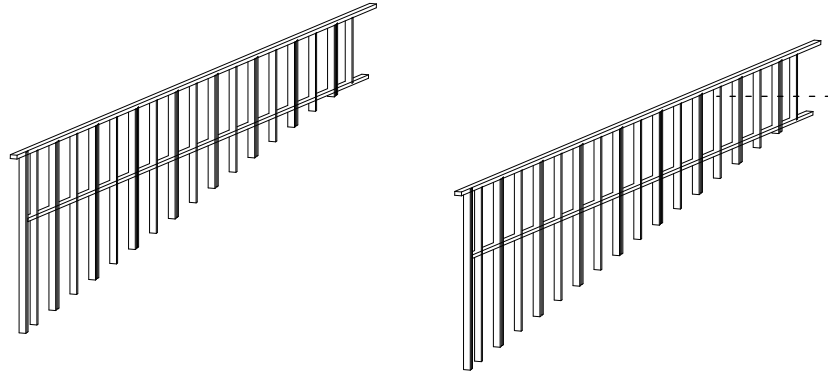

WALL STUDS & FRAMING FOR GLAZING

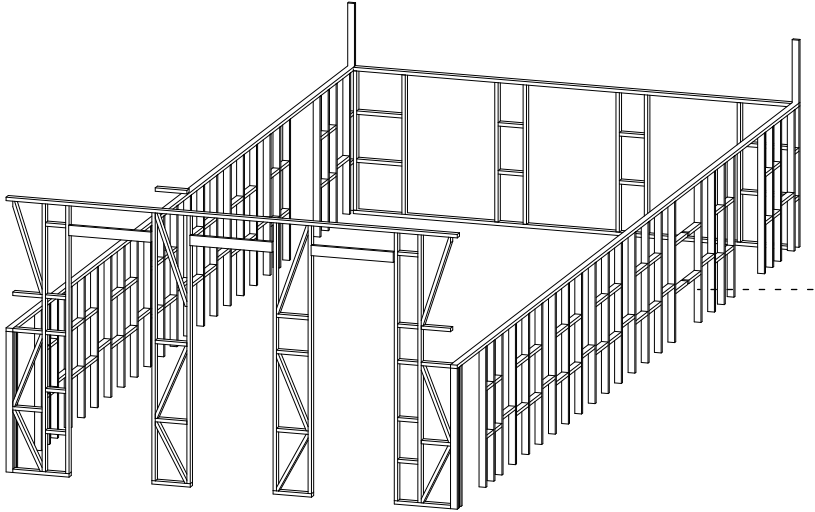


WALL STUDS & FRAMING FOR
WINDOWS AND CLADDING

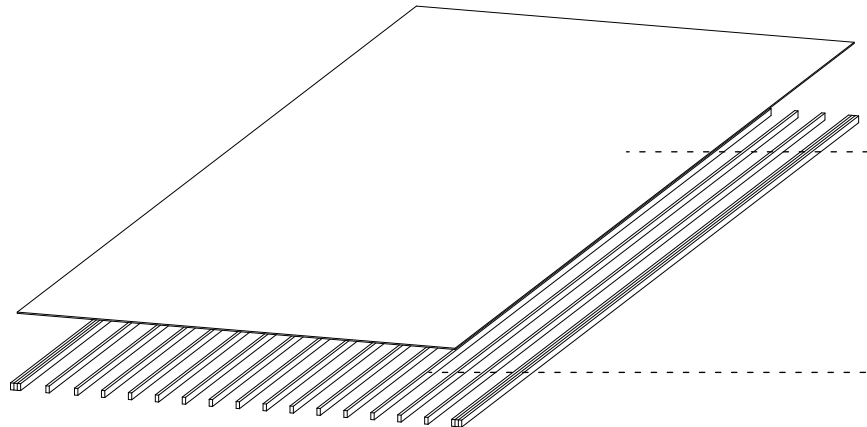

FLOOR BOARDS

FLOOR JOISTS

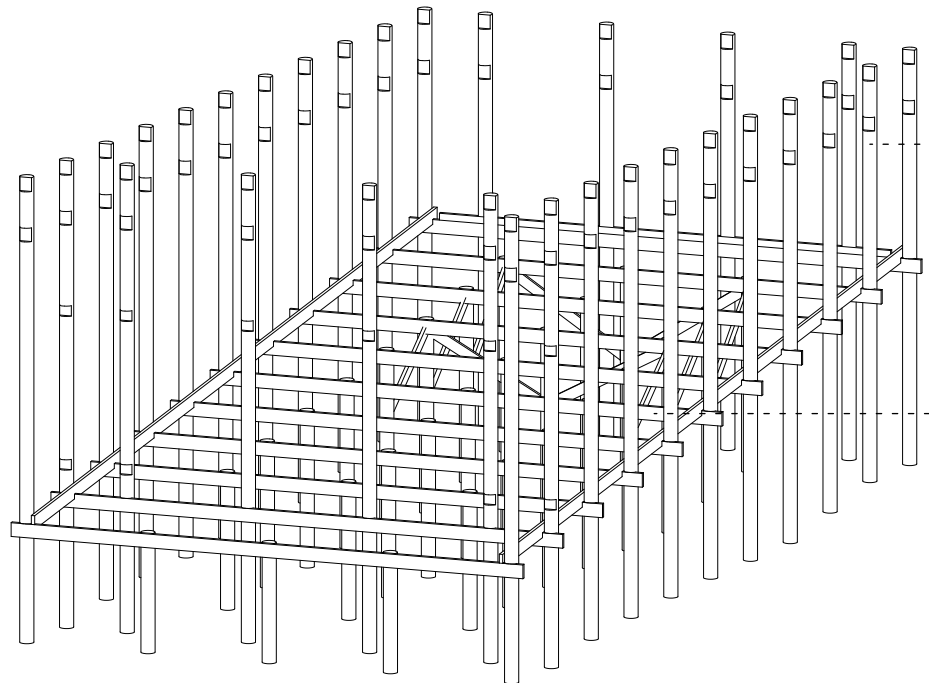

STRUCTURAL PINE POLE COLUMNS

FLOOR BEAMS

